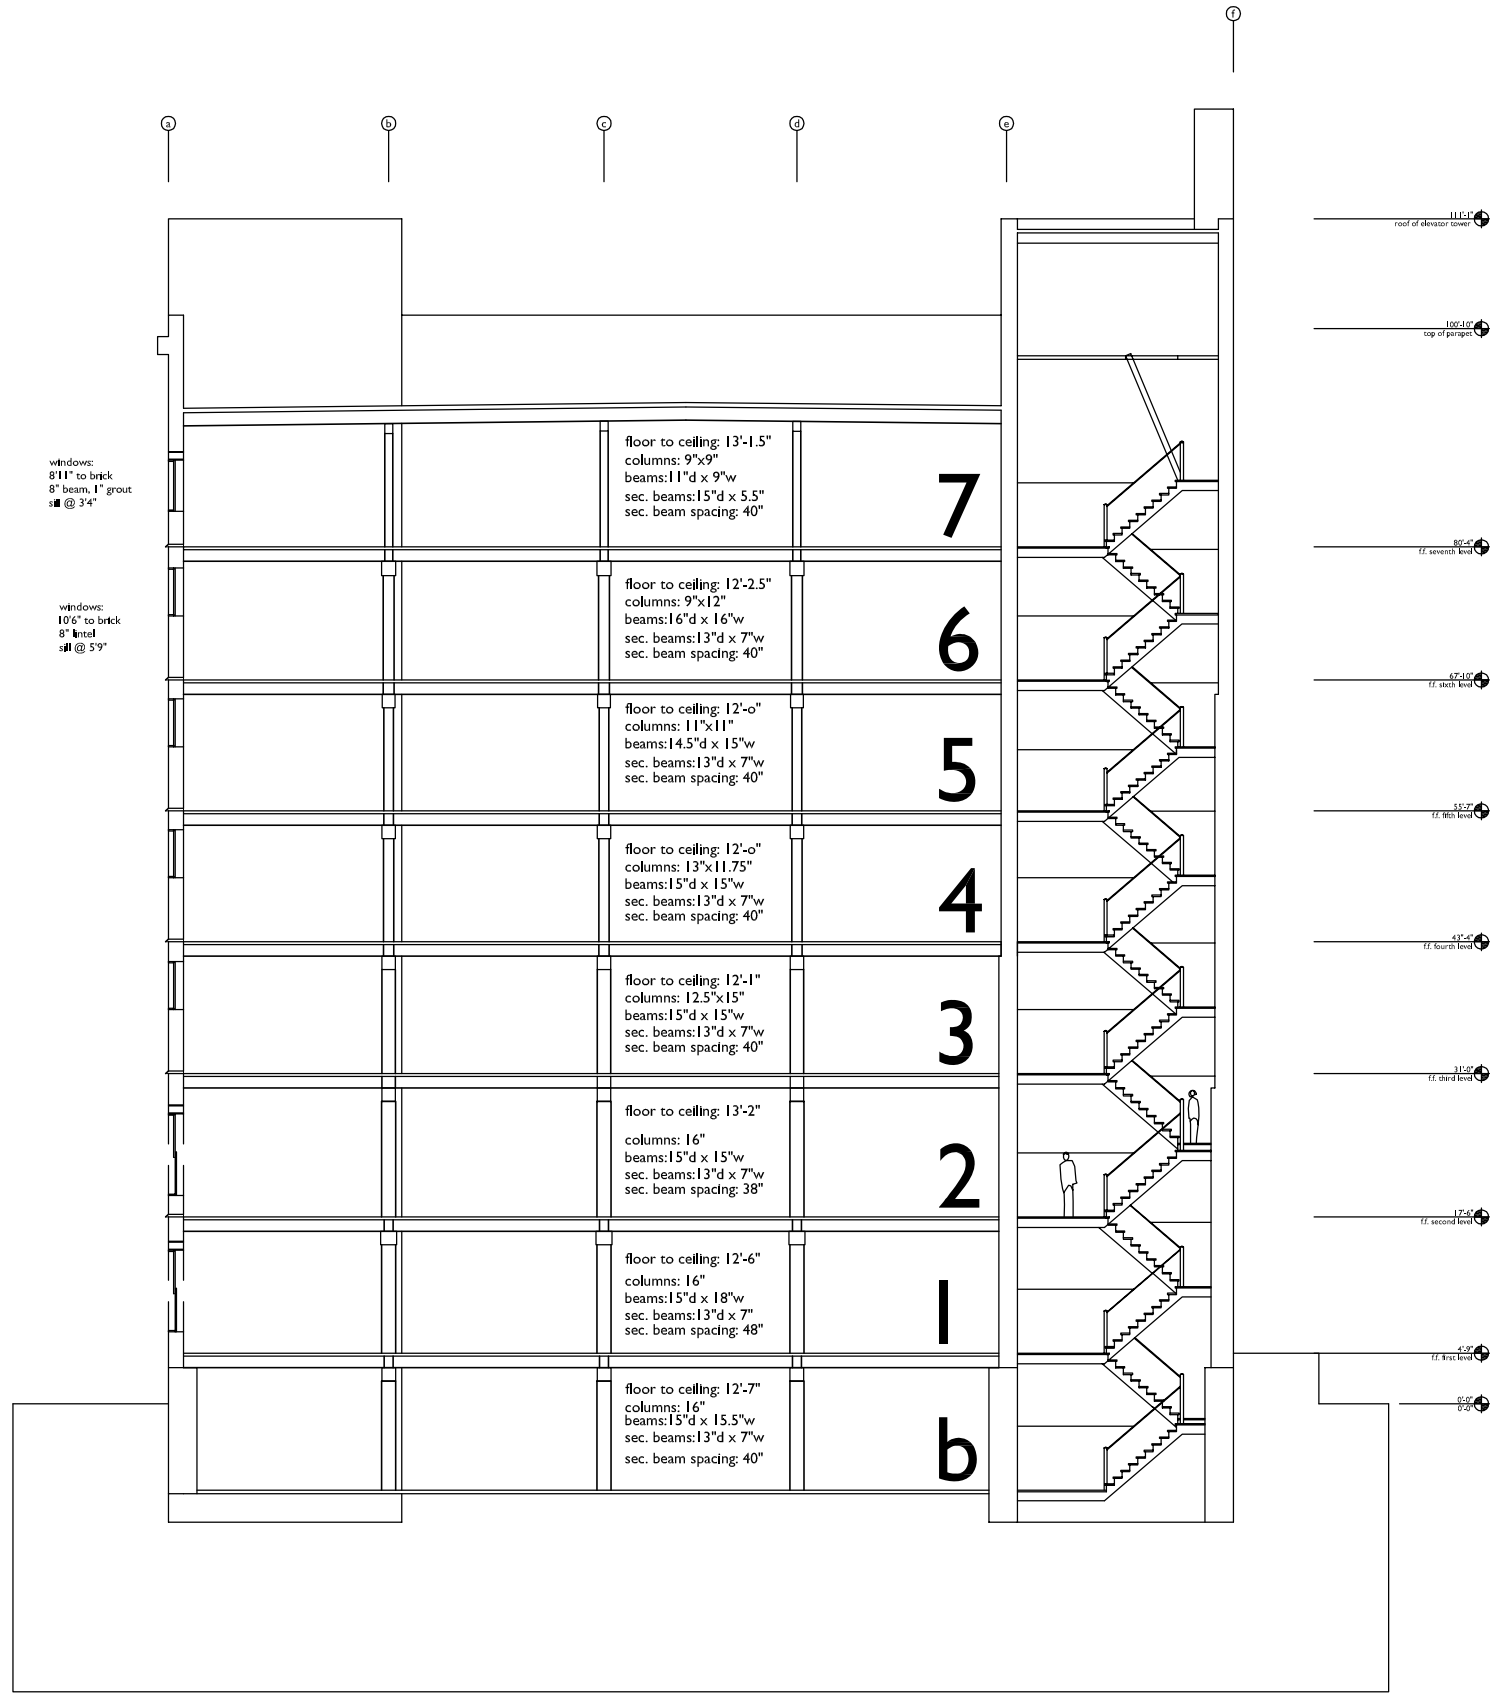

1 n-s section 1/8"=1'-o"

o' 1' 4' 8'

bluedot studio, inc
7o29 wyandotte #9o8
kansas city, mo 641o8
816.564.5667
info@bluedotstudioinc.com

building rehabilitation at:
MOLINE BUILDING
1o15 mulberry street
kansas city, missouri 641o8

as-built drawings

o2 nov 2oo5

a3.o