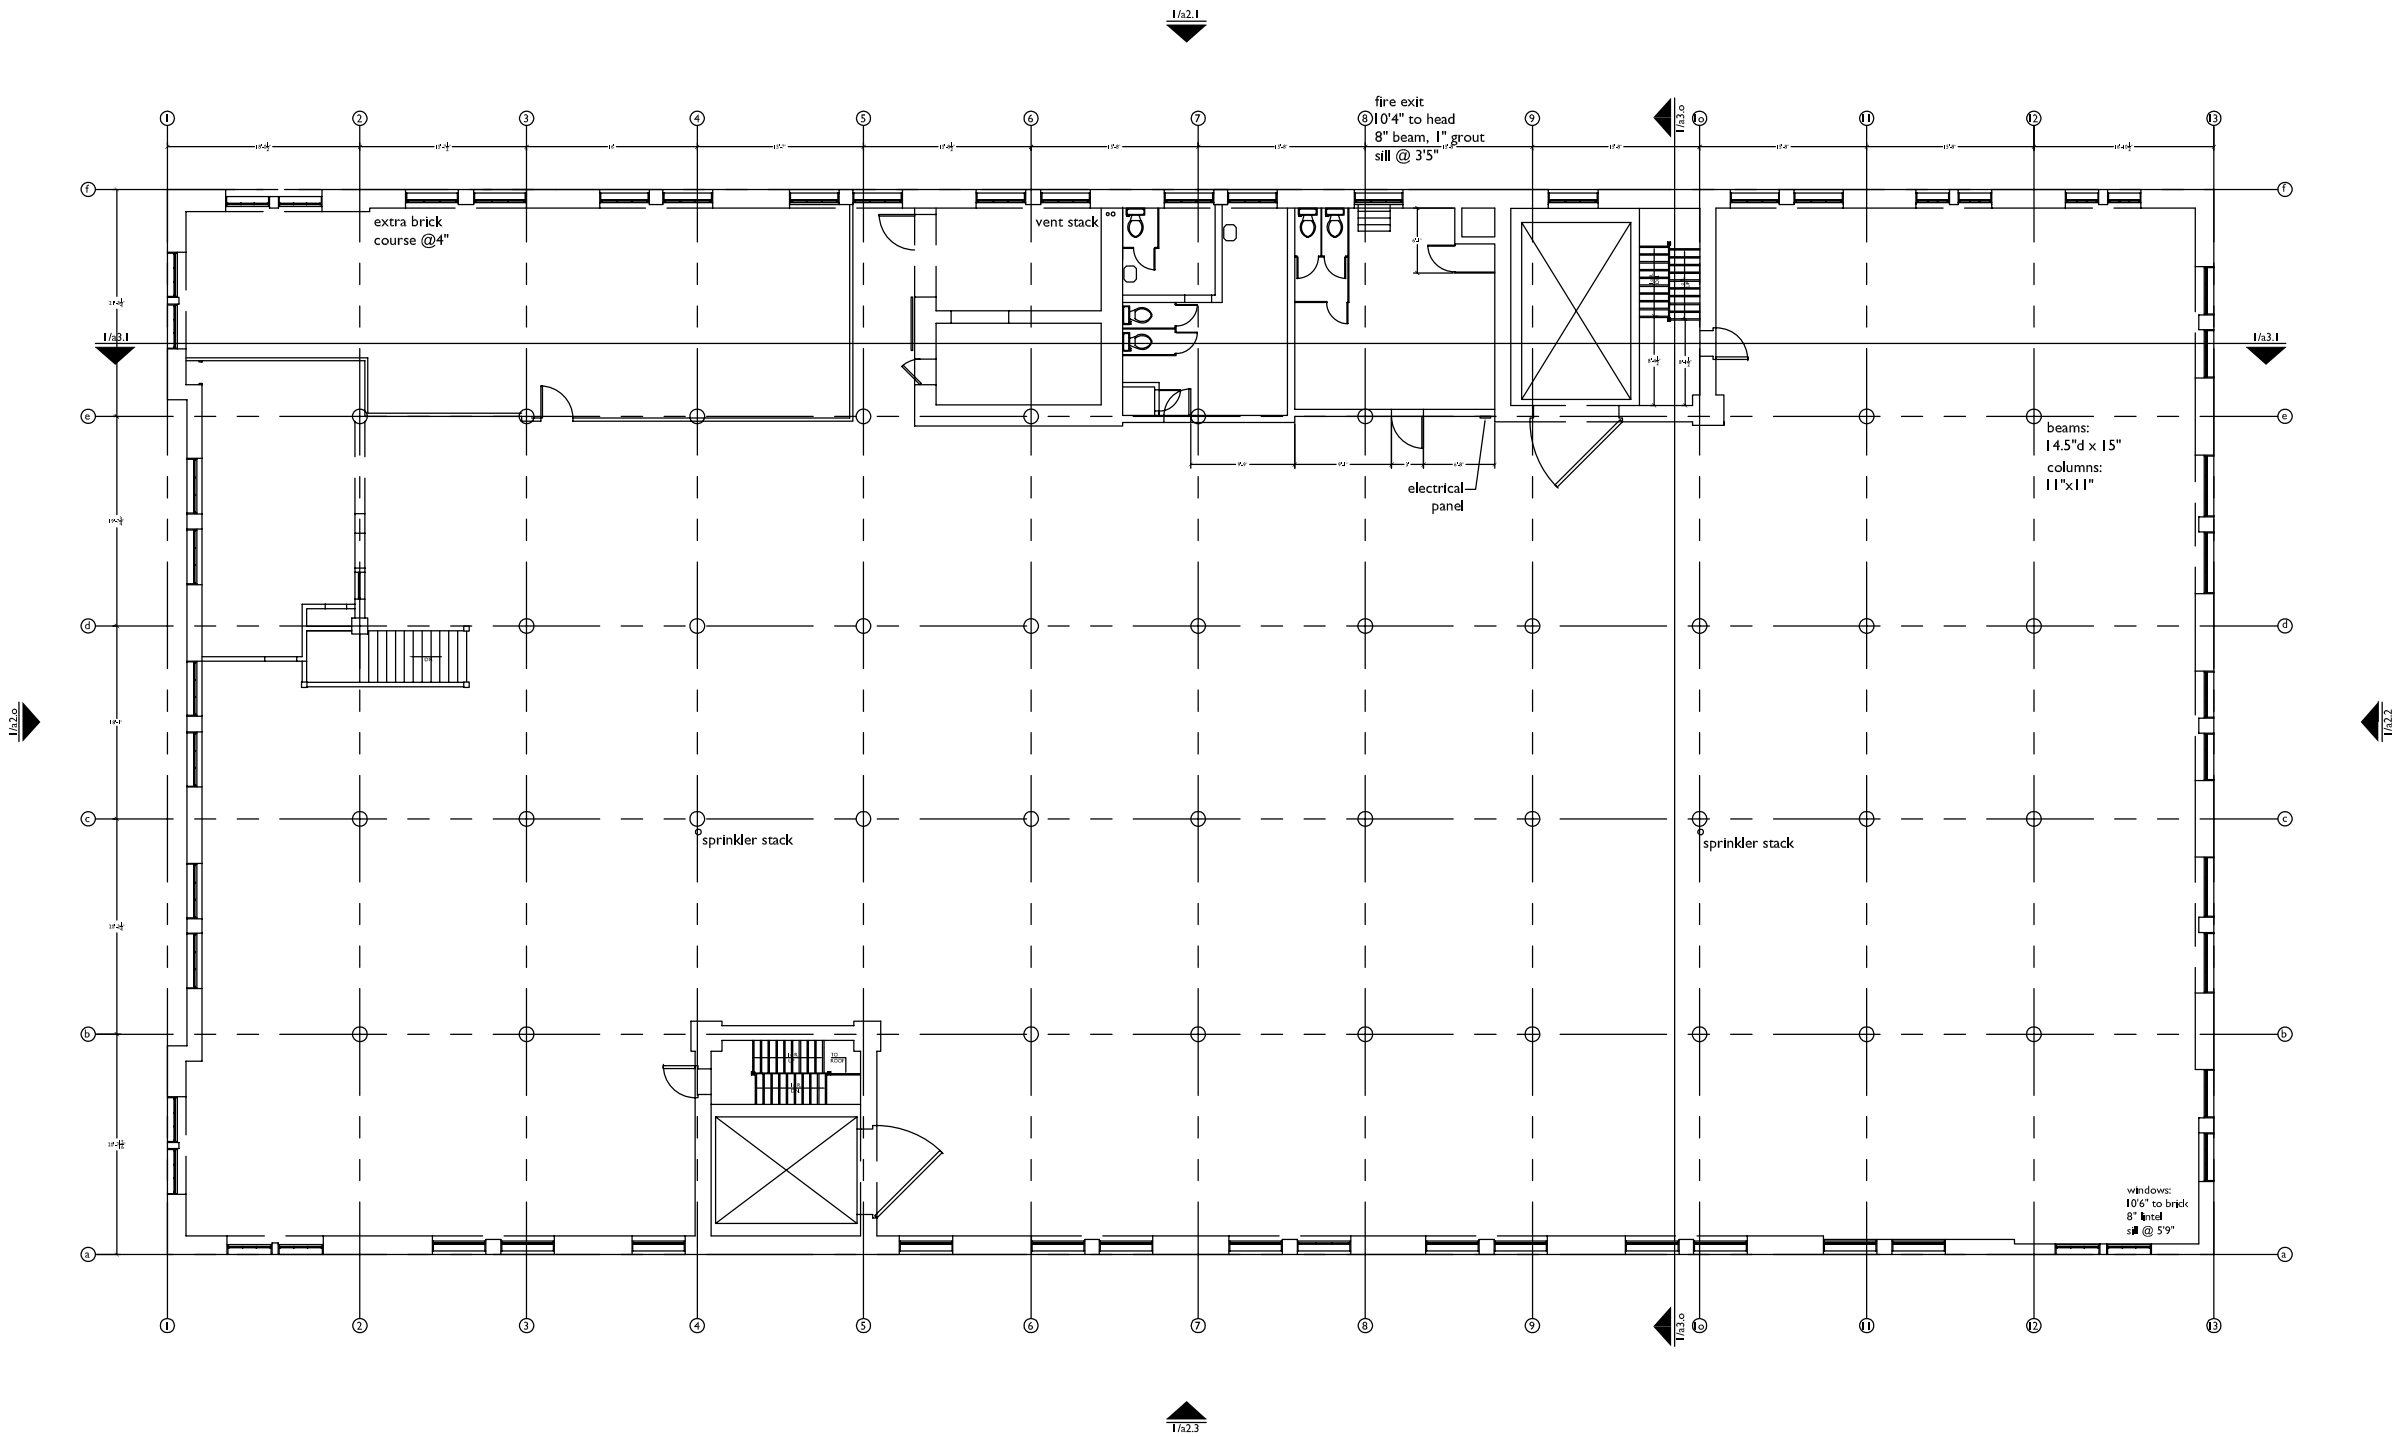

gross sq. ft. = 4852.83 sq. ft.
net sq. ft. = 4157.75 sq. ft.

N

1 plan - level 02

1/8"=1'-0"

0' 1' 4' 8'

bluedot studio, inc
2029 wyandotte #408
kansas city, mo 64108
816.564.5667
info@bluedotstudioinc.com

building rehabilitation at:
MOLINE BUILDING
1015 mulberry street
kansas city, missouri 64108

as-built drawings

02 nov 2005

a1.2