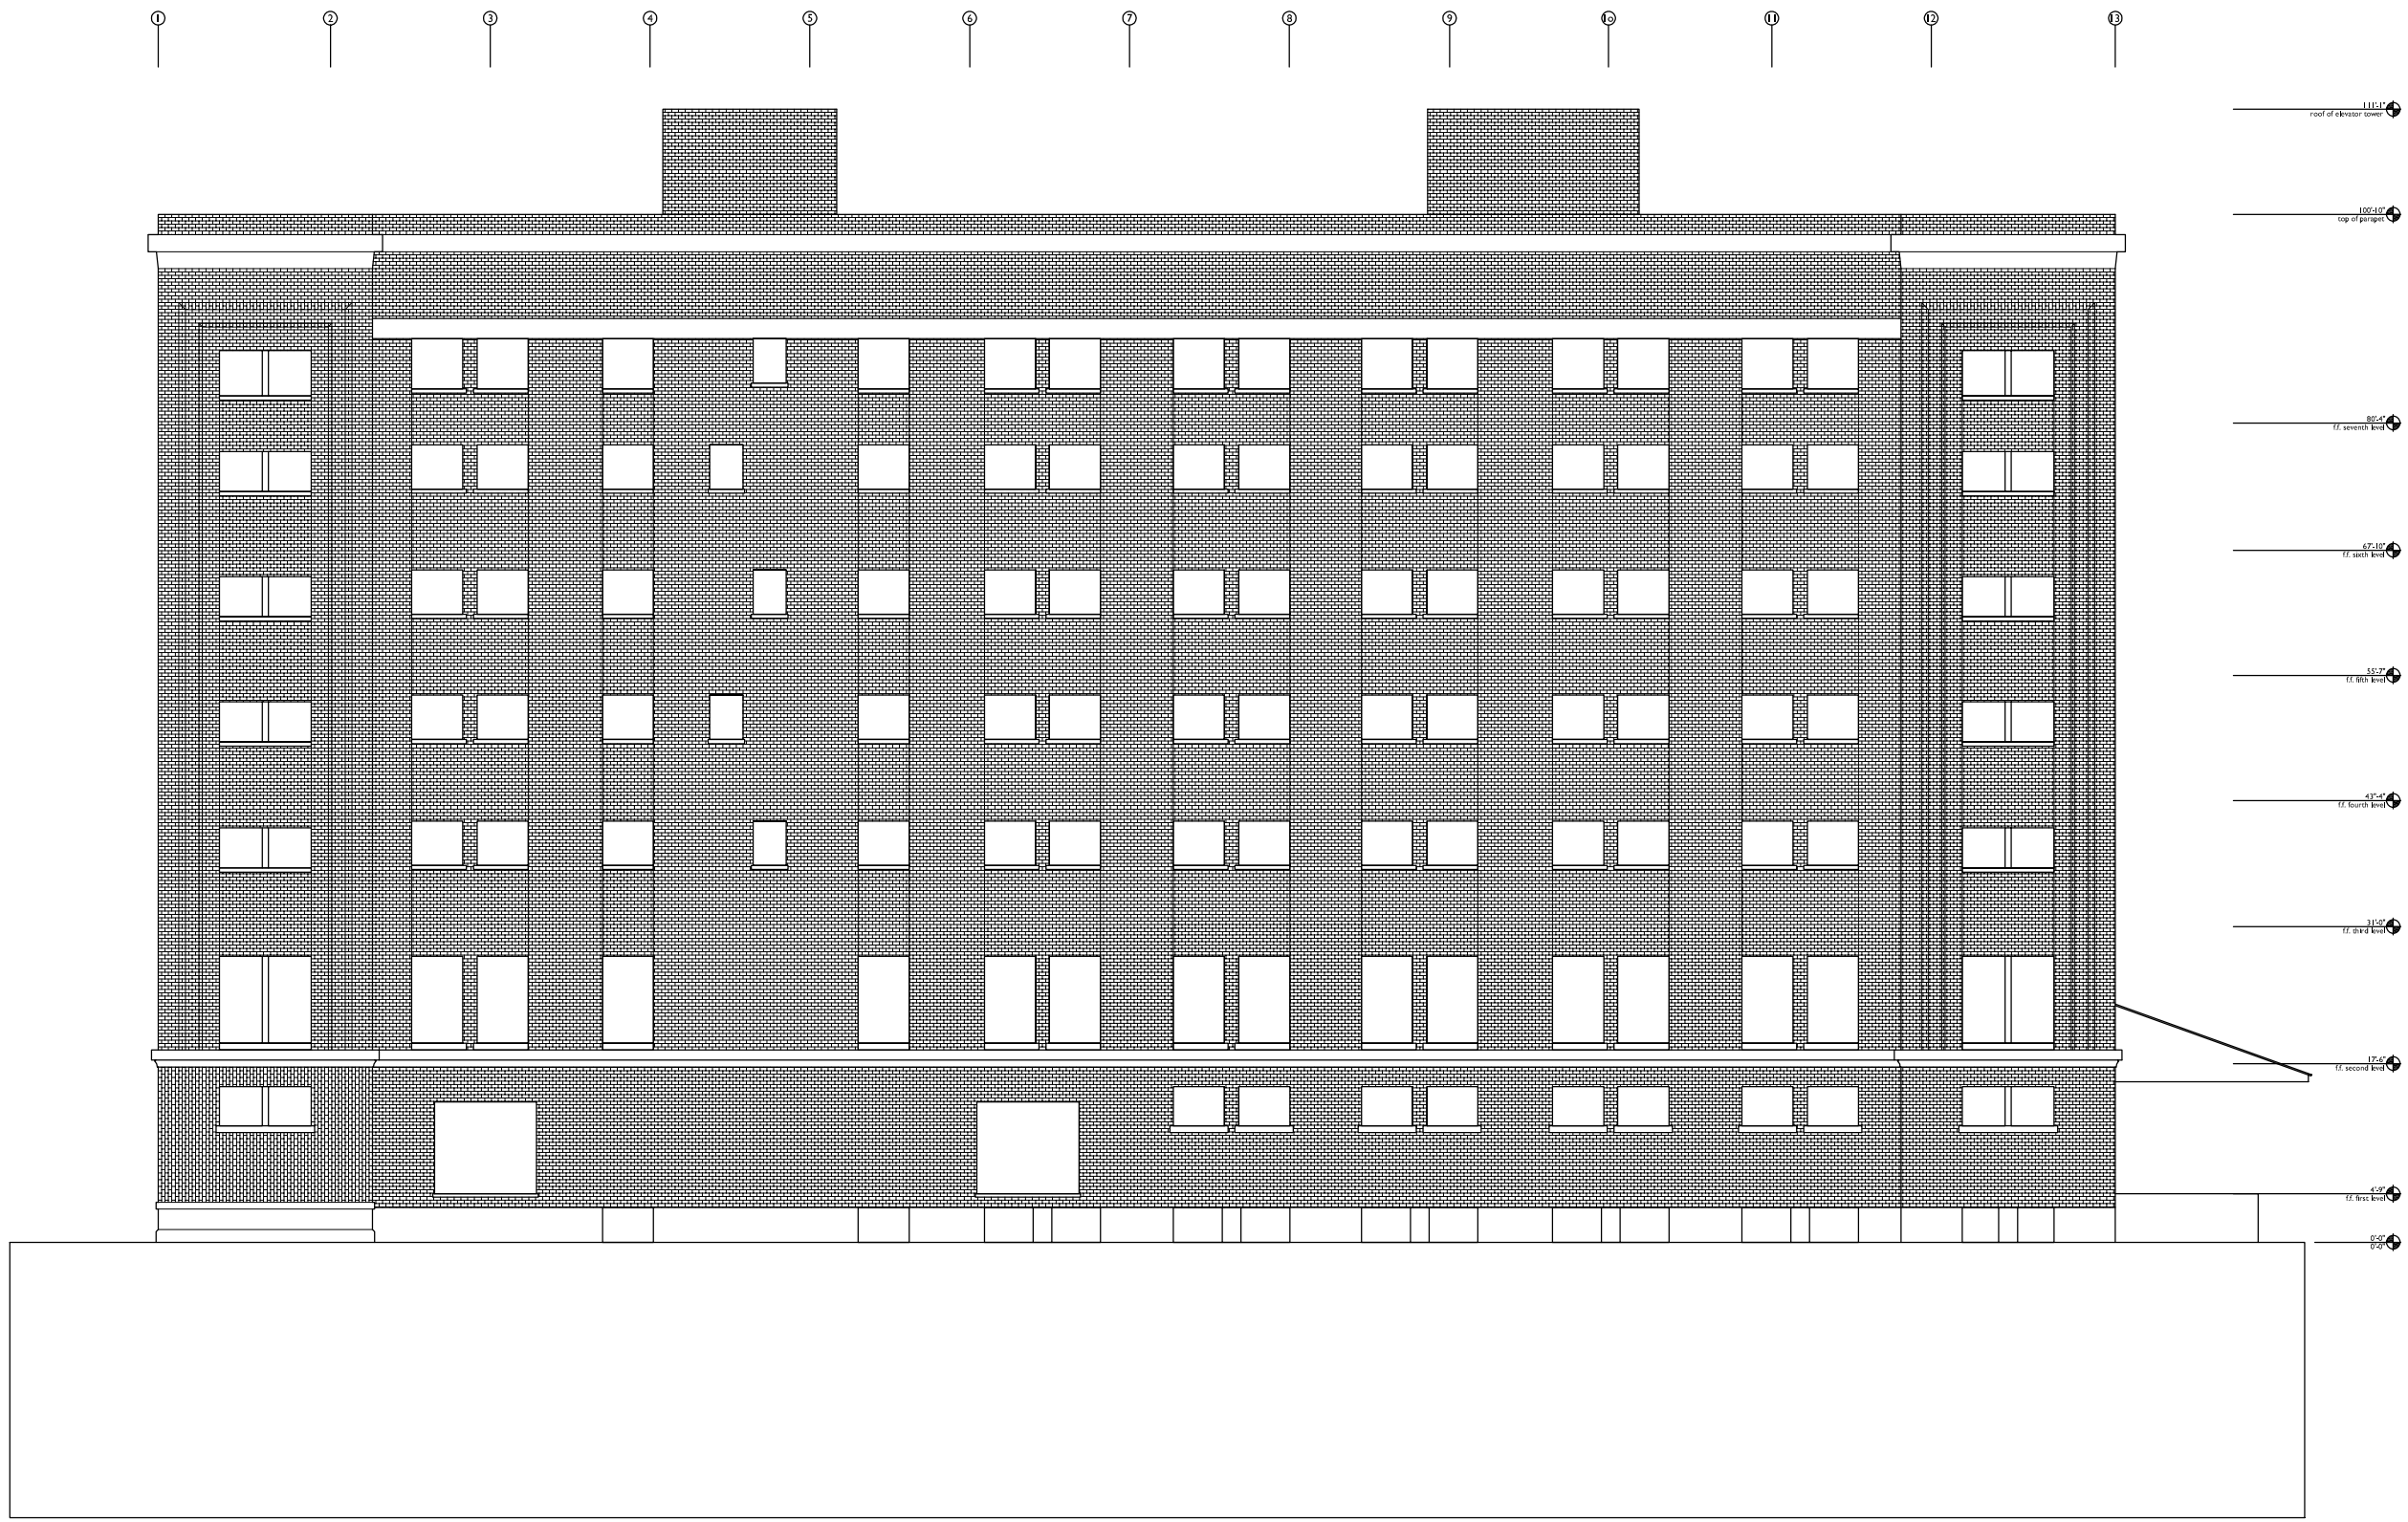

1 south elevation 1/8"=1'-0"

0' 1' 2' 4'

bluedot studio, inc
7o29 wyandotte #468
kansas city, mo 641o8
816.564.5667
info@bluedotstudioinc.com

building rehabilitation at:
MOLINE BUILDING
1o15 mulberry street
kansas city, missouri 641o8

as-built drawings

02 nov 2oo5

a2.3